
# TOSHIBA/HOUSTON

## DRIP-PROOF FULLY-GUARDED HORIZONTAL FOOT-MOUNTED

Fr. 213T-215T

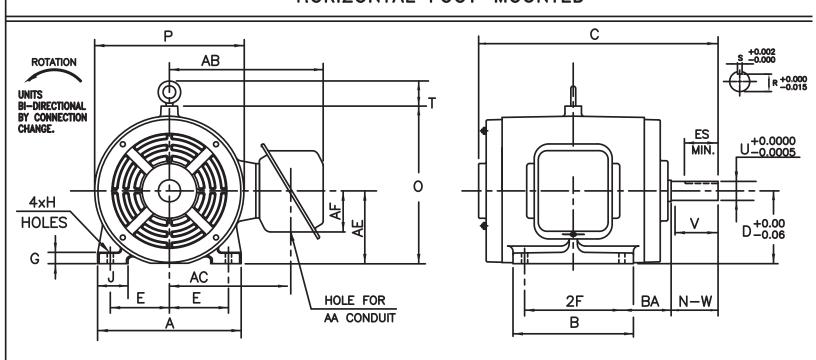

**UNITS: INCHES** 

FRAME	FRAME MOUNTING			CONDUIT BOX							
SIZE	E	2F	Н	BA	AA	AB	AC	AE	AF	XL	XN
213T	4.25	5.50	0.41	3.50	1.0 <del>1.38</del> &	8.19	7.01	5.25	2.61		
215T	4.25	7.00	0.41	3.50	1.0 <del>1.38</del>	8.19	7.01	5.25	2.61		

FRAME	MOTOR DIMENSIONS									
SIZE	Α	В	С	D	G	J	М	0	T	Р
213T	10.24	7.09	15.93	5.25	0.76	1.97	1	10.8	1.65	10.55
215T	10.24	8.66	17.47	5.25	0.76	1.97		10.8	1.65	10.55

FRAME	SHAFT EXTENSION			KEY SEAT			BEARINGS		MAXIMUM	
SIZE	N-W	٧	U	R	S	ES	LS	OS	WEIGHT	
213T/215T	3.38	3.30	1.375	1.201	0.312	2.41	6308ZZ	6208ZZ	170 lbs.	

ALL DATA SUBJECT TO CHANGE WITHOUT NOTICE. FOR CONSTRUCTION USE ONLY CERTIFIED DATA.

## CERTIFIED DATA

#### **NOTES:**

- 1. DIMENSION V REPRESENTS LENGTH OF STRAIGHT PART OF SHAFT.
  2. CONDUIT BOX MAY BE ROTATED IN 90' INCREMENTS AND MAY BE MOUNTED ON OPPOSITE SIDE ON SPECIAL ORDER.
  3. KEY DIMENSIONS EQUAL S x S x 2.41 (MOTOR SUPPLIED WITH KEY)
- 4. MOTOR WEIGHT SHOWN IS MAXIMUM HORSEPOWER IN FRAME.

CUSTOMER:	P.O. NO.:	TAG NO.:
MOTOR MODEL NO.: 0036DPSA31A-P	TOSHIBA FILE NO.:	
HP: _3 RPM (SYN.): _1200	VOLTAGE: 230/460	Hz: 60
FRAME SIZE: 213T LOG N	NO.: LOG	REV. LEVEL:
REMARKS:		
PER: IS	SSUE DATE:	SUPERSEDES:SAS000899

### TOSHIBA INTERNATIONAL CORPORATION

Industrial Division / Houston Motor Plant

INDEX	MPCF-1033
SHEET NO.	1 of 1
ISSUED	11/08/96
SUPERSEDES	10/06/95
REVISION	1
WRITTEN BY	R. EVANS
APPROVED BY	Jay Bugbee

# SQUIRREL CAGE INDUCTION MOTOR PERFORMANCE SPECIFICATIONS

Customer Tag:

CUSTOMER: TIC SR No.: Customer PO:

MOTOR NAMEPLATE DATA						
H.P.: 3	VOLTS: 230/460	3Ø/60	Hz	S. RPM: 1200		
FRAME: 213T	ENCL: ODP	FLAMPS: 10/5		FLRPM: 1180		
FORM: DBK1	S.F.: 1.15	NEMA DESIGN: B		INSUL CLASS: F		
TYPE: IK	AMB.: 40C	CODE: N		DUTY: CONT.		
MODEL No.: 0036DPSA	kW: 2.2		Serial No.:			
NOM. EFF.: 88.5	MIN. EFF.:	P.F.:64				

AMPERAGE	TORQUES	** BEARINGS:
Locked Rotor: 45.1	FULL LOAD (lb-ft.): 13.4 LOCKED ROTOR (%): 300 BREAK DOWN (%): 345	Drive End: 6308ZZ Opposite Drive End: 6208ZZ

EFFICIENCY (%)	POWER FACTOR (%)
FULL LOAD: 88.5	FULL LOAD: 64
3/4 LOAD: 88.4	3/4 LOAD: 56
1/2 LOAD: 86.5	1/2 LOAD: 45.5

ALL CHARACTERISTICS ARE AVERAGE EXPECTED VALUES BASED UPON RATED VOLTAGE, FREQUENCY AND SINEWAVE POWER INPUT.

\* TEMPERATURE RISE WILL BE CONSISTENT WITH INSULATION, AMBIENT AND SERVICE FACTOR AS DEFINED BY NEMA-MG-12.43 OR -20.40.

\*\* BEARINGS ARE THE ONLY RECOMMENDED SPARE PART(S).

CERTIFIED BY: DATE:



Reliability in Motion

#### **TOSHIBA INTERNATIONAL CORPORATION**

INDUSTRIAL DIVISION
PO BOX 40906
HOUSTON TX 77240 (800) 231-1412
(713) 466-0277 FAX (713) 466-8773

#### **SPARE PARTS (RECOMMENDED)**

OTHER THAN THE GREASE USED FOR RE-GREASABLE BEARINGS, TOSHIBA ADVISES THAT THERE ARE NO "USE" PARTS. THE ONLY INSURANCE SPARES THAT TOSHIBA SUGGESTS FOR THESE SQUIRREL CAGE INDUCTION MOTORS ARE INDUSTRY STANDARD, AND COMMERCIALLY AVAILABLE ANTI-FRICTION BEARINGS, AS NOTED BELOW.

MOTOR COMPONENTS (SUCH AS TERMINAL BOXES, FAN COVERS, MACHINED PARTS) ARE AVAILABLE UPON SPECIAL REQUEST. IN THIS CASE, PLEASE ADVISE OUR ORDER ENTRY DEPARTMENT THE MODEL AND SERIAL NUMBERS (FOUND ON THE MOTOR NAMEPLATE), AND A DESCRIPTION OF THE COMPONENT REQUIRED. THEY WILL THEN FURNISH THE CURRENT PART NUMBER, PRICE AND AVAILABILITY.

(NOTE: OUR INTERNAL PART NUMBERS ARE SUBJECT TO CHANGE WITHOUT NOTICE, AND ARE NOT PUBLISHED).

PLEASE ADVISE IF YOU HAVE ANY QUESTIONS.

CUSTOMER:
PURCHASE ORDER #
Customer Tag:

TOSHIBA FILE #

MODEL # 0036DPSA31A-P

HP/RPM/ENCL/FRAME: 3 / 1200 / ODP / 213T

DRIVE END BEARING: 6308ZZ
OPPOSITE DRIVE END BEARING: 6208ZZ

Prepared By: Date: